
NA.

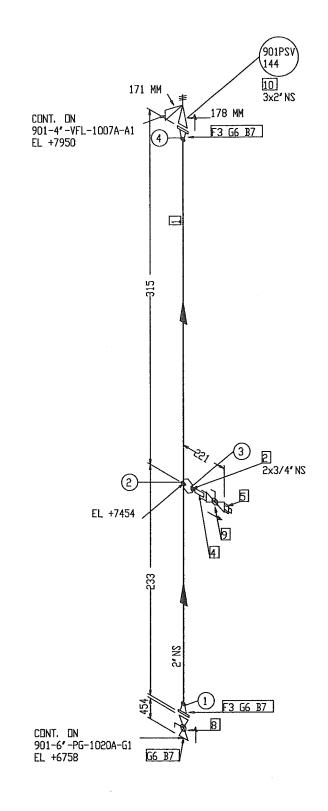

- NOTES:

 1. CONTRACTOR TO DECIDE ON FIELD WELDS AND EXTRA SPOOL LENGTH WHEREVER NECESSARY.

 2. WELD NO. 1 TO 6

"AS - BUILT"

FOR MAIN LINE
: 241.3 BARG
: 128° C
: 361.95 BARG

1. DE 2. OPERATING TEMPERATURE

3. HYDROSTATIC TEST PRESSURE

4. CORROSION ALLOWANCE 5. RADIOGRAPHY
6. INSULATION
7. INSPECTION BY
8. PWHT

: 100% : PP : GSI (QC) : NO

: 1/8"

BILL OF MATERIAL

	FABRICATION MATERIALS			
PT ND	COMPONENT DESCRIPTION	N. S. (2NI)	PIPE SPEC,	QTY
1 2 3	PIPE SMLS BE XXS A106 GR. B, NACE WELDDLET XXS A105, NACE FLANGE 2500LB WN RTJ XXS A105, NACE	2 2 x 3/4 2	G1 G1 G1	0. 3M 1 2
	ERECTION MATERIALS			
PT ND	COMPONENT DESCRIPTION	N. S. (2NS)	PIPE SPEC.	QTY
4	75mm LG PIPE NIPPLE TOE XXS A106 GR. B, NACE	3/4	G1	1
5	PLUG SCRD 6000LB A105, NACE	3/4	G1	1
6	R26 DVAL RING SOFT IRON BHN90 ZINC COATED	5	G1	3
7	185 MM LG STUD BOLTS C/W NUTS A193 GR. B7/A194 GR. 2H HOT-DIP GALV, COATED	1	G1	24
8	BALL VALVE 2500LB RTJ, BV-48 (FB)(CSC)	2	G1	1
9	BALL VALVE THREADED PER PIPING SPEC. G1	3/4	G1	1
10	901PSV 144	3 x 2		1

				T	
			1/	1	
		[]	Cen	DD	
xo	AS BUILT	AR	RAGU	SD	09.04.1
1	AS BUILT	ŃN	CG	SD	07.06.1
0	APPROVED FOR CONSTRUCTION	FT	BS	SD	17.04.0
REV. NO	DESCRIPTION OF REVISION	BY	CHK'D	APP'D	DATE

OOG K

ROJECT:		FF	JD9 ND. 21-9791	
		F	CHMIXITE 1	
ITLE:			901-2"-PG-1032A-G	CLASS I ABS
PIPING	ISOMETRIC	901-2"-PG-1032A-G 901-2"-PG-1032B-G	7000-04-L-26-XN-05121	
SI DISCIPLINE	SIEN	AFTROVED BY	BORT 6500	

					 -	
I DISCIPLINE SIGN			AF7ROVED BY	Ð	Т	
ŒSS	'AR	\sim	DE0020 87		 1	-
HANICAL	VC		DRAIGH BY	IAGU	 _	•
INS	附	1	FT			1/
LICTURAL	WICH		SCALE N.		 7	w

wasco Gas Services International (S) Pte Ltd

JSL

GSI-G375-5121 JURONG SHIPYARD PTE LTD

__XXX __ SECTION