

- NOTES:
- CONTRACTOR TO DECIDE ON FIELD WELDS AND EXTRA SPOOL LENGTH WHEREVER NECESSARY.
 - WELD NO. ① TO ⑪

"AS - BUILT"

DESIGN DATA	
DESIGN PRESSURE	: 43.8 BARG
OPERATING TEMPERATURE	: 49° C
HYDROSTATIC TEST PRESSURE	: 65.7 BARG
CORROSION ALLOWANCE	: 1/8"
RADIOGRAPHY	: 100%
INSULATION	: NO
INSPECTION BY	: GSI (QC)
PWHT	: NO

BILL OF MATERIAL

PT NO	COMPONENT DESCRIPTION	N. S. (INS)	PIPE SPEC.	QTY
1	PIPE SMLS BE XS A106 GR. B, NACE	14	B1	1.6M
2	45 DEG LR ELBOW SMLS BW XS A234 GR. WPB, NACE	14	B1	1
3	WELDLET XS x SCH 160 A105, NACE	14 x 3/4	B1	1
4	90 DEG LR ELBOW SMLS BW XS A234 GR. WPB, NACE	14	B1	2
5	FLANGE 300LB WN RF SCH 160 A105, NACE	14	B1	2
6	FLANGE 300LB WN RF SCH 160 A105, NACE	3/4	B1	1

ERECTION MATERIALS

PT NO	COMPONENT DESCRIPTION	N. S. (INS)	PIPE SPEC.	QTY
7	SPIRAL WOUND GASKET 300LB RF 4.5mm THK SS316 WINDING/GRAPHITE FILLER W/3mm THK CS CENTERING RING, ZINC COATED	14	B1	1
8	185 MM LG STUD BOLTS C/V NUTS A193 GR. B7/A194 GR. 2H HOT-DIP GALV. COATED	1. 1/8	B1	20
9	SPIRAL WOUND GASKET 300LB RF 4.5mm THK SS316 WINDING/GRAPHITE FILLER W/3mm THK CS CENTERING RING, ZINC COATED	3/4	B1	1
10	123 MM LG STUD BOLTS C/V NUTS A193 GR. B7/A194 GR. 2H HOT-DIP GALV. COATED	5/8	B1	4
11	DB&B SLIM-LINE INSTRUMENT MONOFLANGE 300LB	3/4	B1	1
12	901PI 110	3/4		1

X0	AS BUILT	AR	RAGU	SD	09.04.12
4	MODIFIED & ISSUED FOR CONSTRUCTION	RAGU	BS	SD	02.03.11
3	AS BUILT	FT	BS	SD	07.06.10
2	REDRAWN PER GSI'S COMMENTS	NN	CG	SD	14.05.08
1	REVISED PER P&ID CHANGES	NN	CG	SD	17.04.08
0	APPROVED FOR CONSTRUCTION	SHU	CG	SD	27.03.08
REV. NO	DESCRIPTION OF REVISION	BY	CHKD	APPD	DATE

CLIENT : **OOG TK FPSO**

PROJECT : **FPSO CIDADE DEITAJAI**

JOB NO. : **21-9791**

QUANTITY : **1**

CLASS : **ABS**

TITLE : **PIPING ISOMETRIC**

LINE NO : **901-14"-PG-1001A-B1 (SHT.1/2)**
901-14"-PG-1001B-B1 (SHT.1/2)


TYPE DRAWING NO. : **7000-04-L-26-XN-05121**

WASCO Gas Services International (S) Pte Ltd

JSL **JURONG SHIPYARD PTE LTD**
(A subsidiary of SembCorp Marine Ltd)

ENGINEERING DEPARTMENT : **XXX** SECTION

DESIGN : **G375-5121-08_X0** JOB NO : **G375** SHT : **08** REV : **X0**

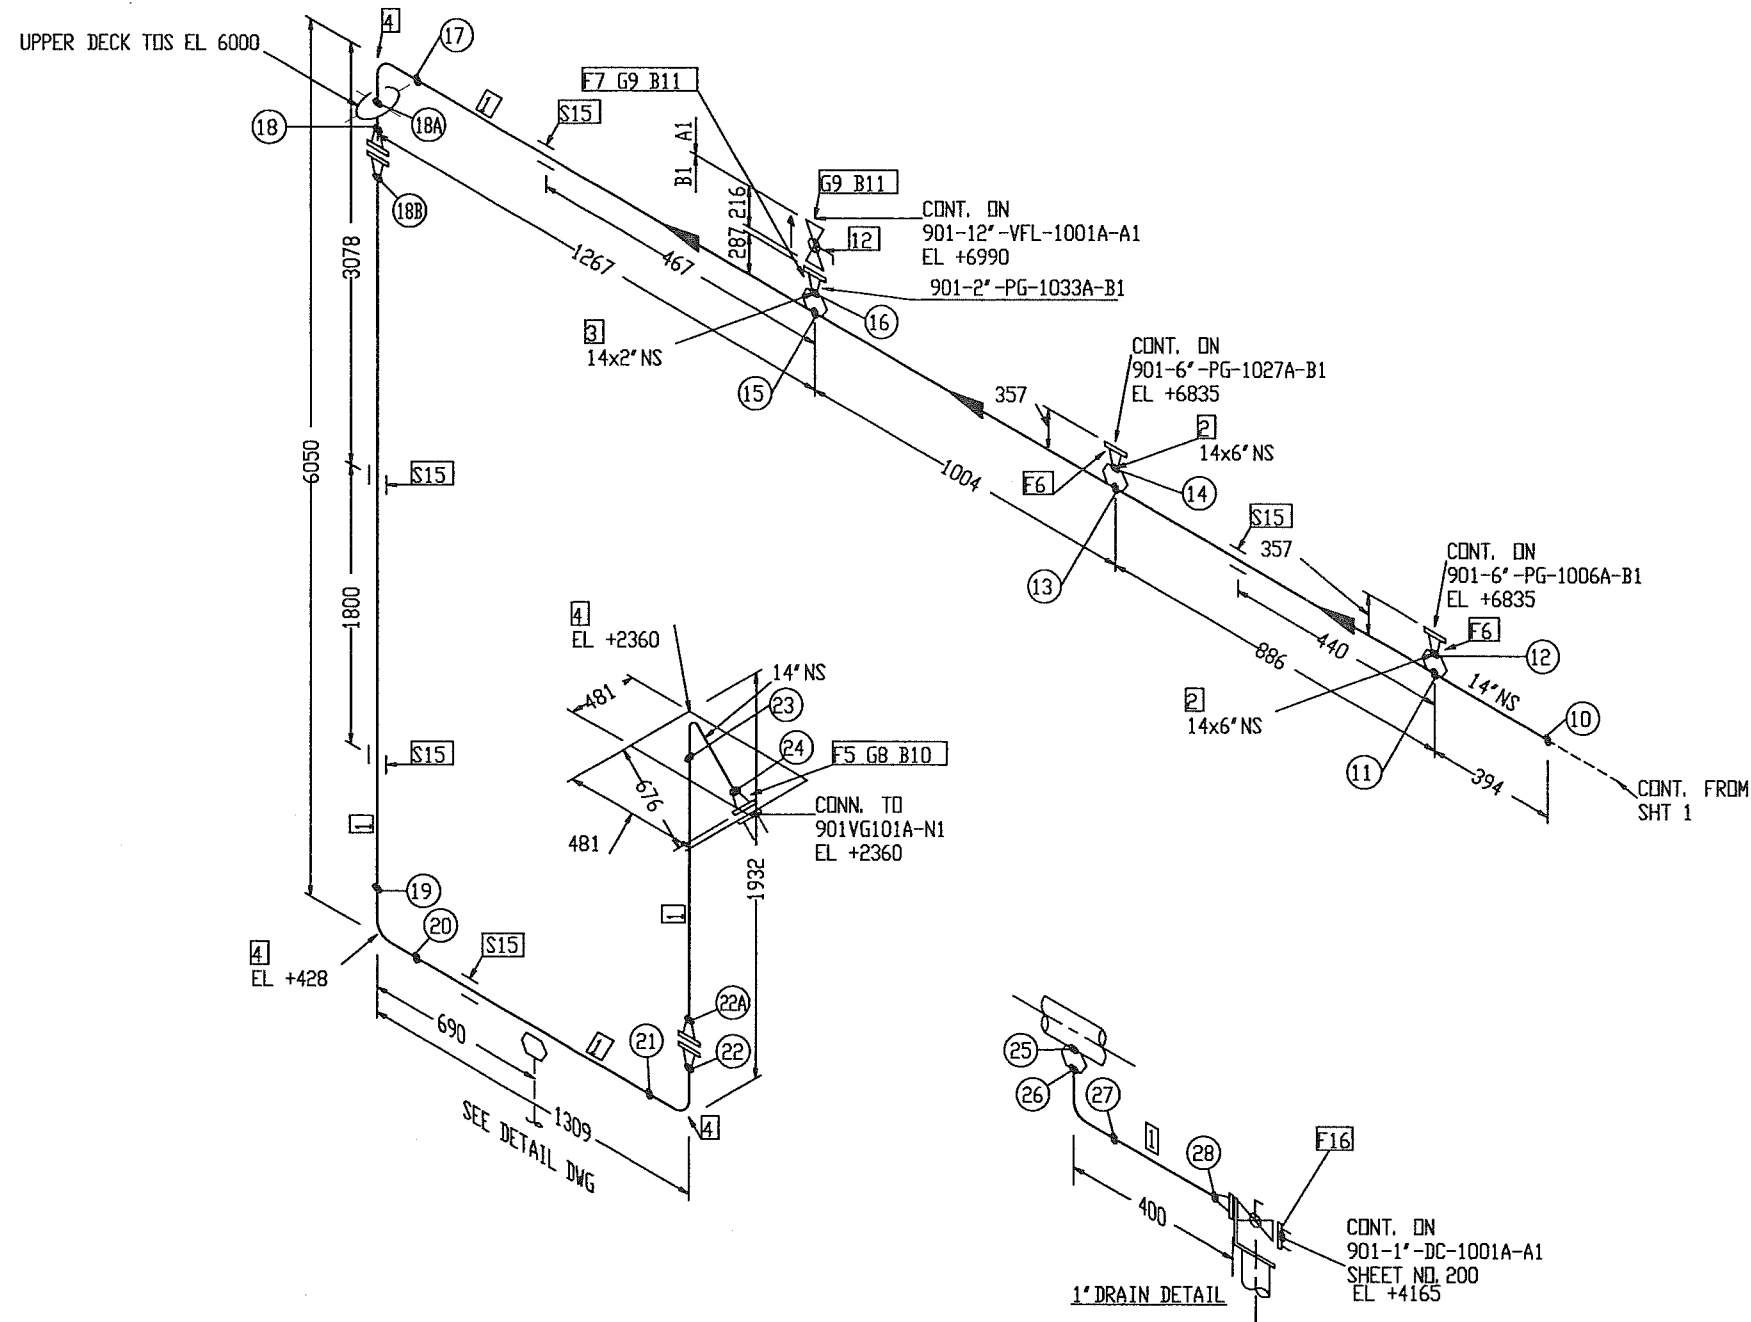

"AS - BUILT"

- NOTES:
- CONTRACTOR TO DECIDE ON FIELD WELDS AND EXTRA SPOOL LENGTH WHEREVER NECESSARY.
 - WELD NO. (10) TO (28)

DESIGN DATA	
1. DESIGN PRESSURE	: 43.8 BARG
2. OPERATING TEMPERATURE	: 49° C
3. HYDROSTATIC TEST PRESSURE	: 65.7 BARG
4. CORROSION ALLOWANCE	: 1/8"
5. RADIOGRAPHY	: 100%
6. INSULATION	: NO
7. INSPECTION BY	: GSI (QC)
8. PWHT	: NO

BILL OF MATERIAL

FABRICATION MATERIALS

PT NO	COMPONENT DESCRIPTION	N. S. (INS)	PIPE SPEC.	QTY
1	PIPE SMLS BE XS A106 GR. B, NACE	14	B1	9.2M
2	WELDOLET XS A105, NACE	14 x 6	B1	2
3	WELDOLET XS A105, NACE	14 x 2	B1	1
4	90 DEG LR ELBOW SMLS BW XS A234 GR. WPB, NACE	14	B1	4
5	FLANGE 300LB WN RF XS A105, NACE	14	B1	1
6	FLANGE 300LB WN RF SCH 80 A105, NACE	6	B1	2
7	FLANGE 300LB WN RF SCH 80 A105, NACE	2	B1	1
7A	FLANGE 300LB WN RF SCH 160 A105, NACE	1	B1	1
7B	BLIND FLANGE 300LB RF A105 NACE	1	B1	1

ERECTION MATERIALS

PT NO	COMPONENT DESCRIPTION	N. S. (INS)	PIPE SPEC.	QTY
8	SPIRAL WOUND GASKET 300LB RF 4.5mm THK SS316 WINDING/GRAPHITE FILLER W/3mm THK CS CENTERING RING, ZINC COATED	14	B1	1
9	SPIRAL WOUND GASKET 300LB RF 4.5mm THK SS316 WINDING/GRAPHITE FILLER W/3mm THK CS CENTERING RING, ZINC COATED	2	B1	2
9A	SPIRAL WOUND GASKET 300LB 4.5mm THK SS316 WINDING/GRAPHITE FILLER W/3mm THK CS CENTERING RING, ZINC COATED	1	B1	2
10	185 MM LG STUD BOLTS C/W NUTS A193 GR. B7/A194 GR. 2H HOT-DIP GALV. COATED	1. 1/8	B1	20
11	95 MM LG STUD BOLTS C/W NUTS A193 GR. B7/A194 GR. 2H HOT-DIP GALV. COATED	5/8	B1	16
11A	85 MM LG STUD BOLTS C/W NUTS A193 GR. B7/A194 GR. 2H HOT-DIP GALV. COATED	5/8	B1	8
12	BALL VALVE 300LB RF, BV-24 (CSC)	2	B1	1
12A	BALL VALVE 300LB RF	1	B1	1
13	WELDOLET SCH 160 A105, NACE	14 X 1	B1	1
14	90 DEG LR ELBOW SMLS BW SCH 160 A234 GR WPB	1	B1	1

SUPPORTS

15	STD TTI CLAMP	14	B1	5
16	FLANGE 300LB SW RF SCH 160 A105, NACE	1	B1	1

XO	AS BUILT	AR	RAGU	SD	09.04.12
4	REVISED AS SHOWN	RAGU	LYC	SD	01.12.11
3	AS BUILT	FT	BS	SD	07.06.10
2	REVISED AS SHOWN	FT	BS	SD	20.08.08
1	REVISED PER P&ID CHANGES	NN	CG	SD	17.04.08
0	APPROVED FOR CONSTRUCTION	SHU	CG	SD	27.03.08
REV. NO	DESCRIPTION OF REVISION	BY	CHKD	APPD	DATE

CLIENT :



PROJECT:	FPSO CIDADE DEITAJÁ	JOB NO.	21-8791
TITLE:	PIPING ISOMETRIC	QUANTITY:	1
LINE NO.	901-14"-PG-1001A-B1 sht 2/2 901-14"-PG-1001B-B1 sht 2/2	CLASS :	ABS
TRIP OPERATING. NO.	7000-04-L-26-XN-05121		

GS1 DISCIPLINE SIGN	APPROVED BY	SD
PROCESS	VC	SD
MECHANICAL	VC	SD
PIPING	VC	SD
STRUCTURAL	VC	SD
E & I	VC	SD
PROJECT	EG	SD
WASCO	Gas Services International (S) Pte Ltd	
JSL	JURONG SHIPYARD PTE LTD	
ENGINEERING DEPARTMENT	XXX	SECTION